


2nd Floor Keyplan

SCALE: 1"=100'-0"



0 5' 10' 20'

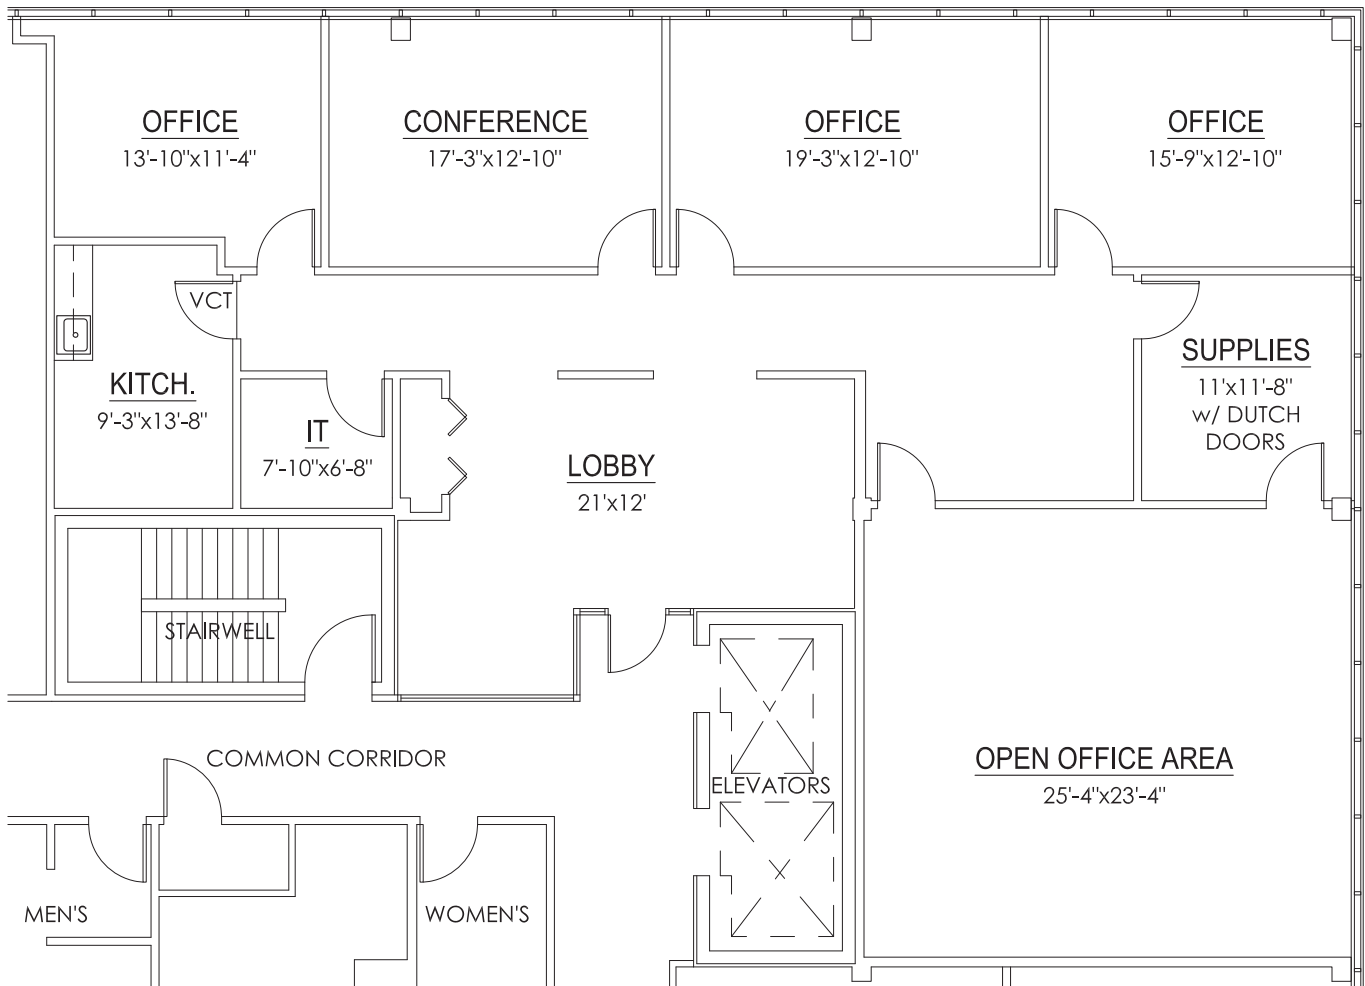

GRAPHIC SCALE



Suite 201 - 2,835 R.S.F.

SCALE: 1"=10'-0"

04/10/18

AS-BUILT PLAN FOR:

Bingham IV
30300 Telegraph Road, Suite 201

smith + schurman associates, inc.
architects ■ planners ■ interior designers

280 n. old woodward ave., suite LL10, birmingham, mi 48009
telephone: 248/332-3140 facsimile: 248/332-3277



JFK INVESTMENT COMPANY, L.L.C.

A MICHIGAN LIMITED LIABILITY COMPANY
43252 WOODWARD AVE-SUITE 210-BLOOMFIELD HILLS, MI 48302
PHONE: (248) 333-2373 - FAX: (248) 333-2873