


BECK ROAD

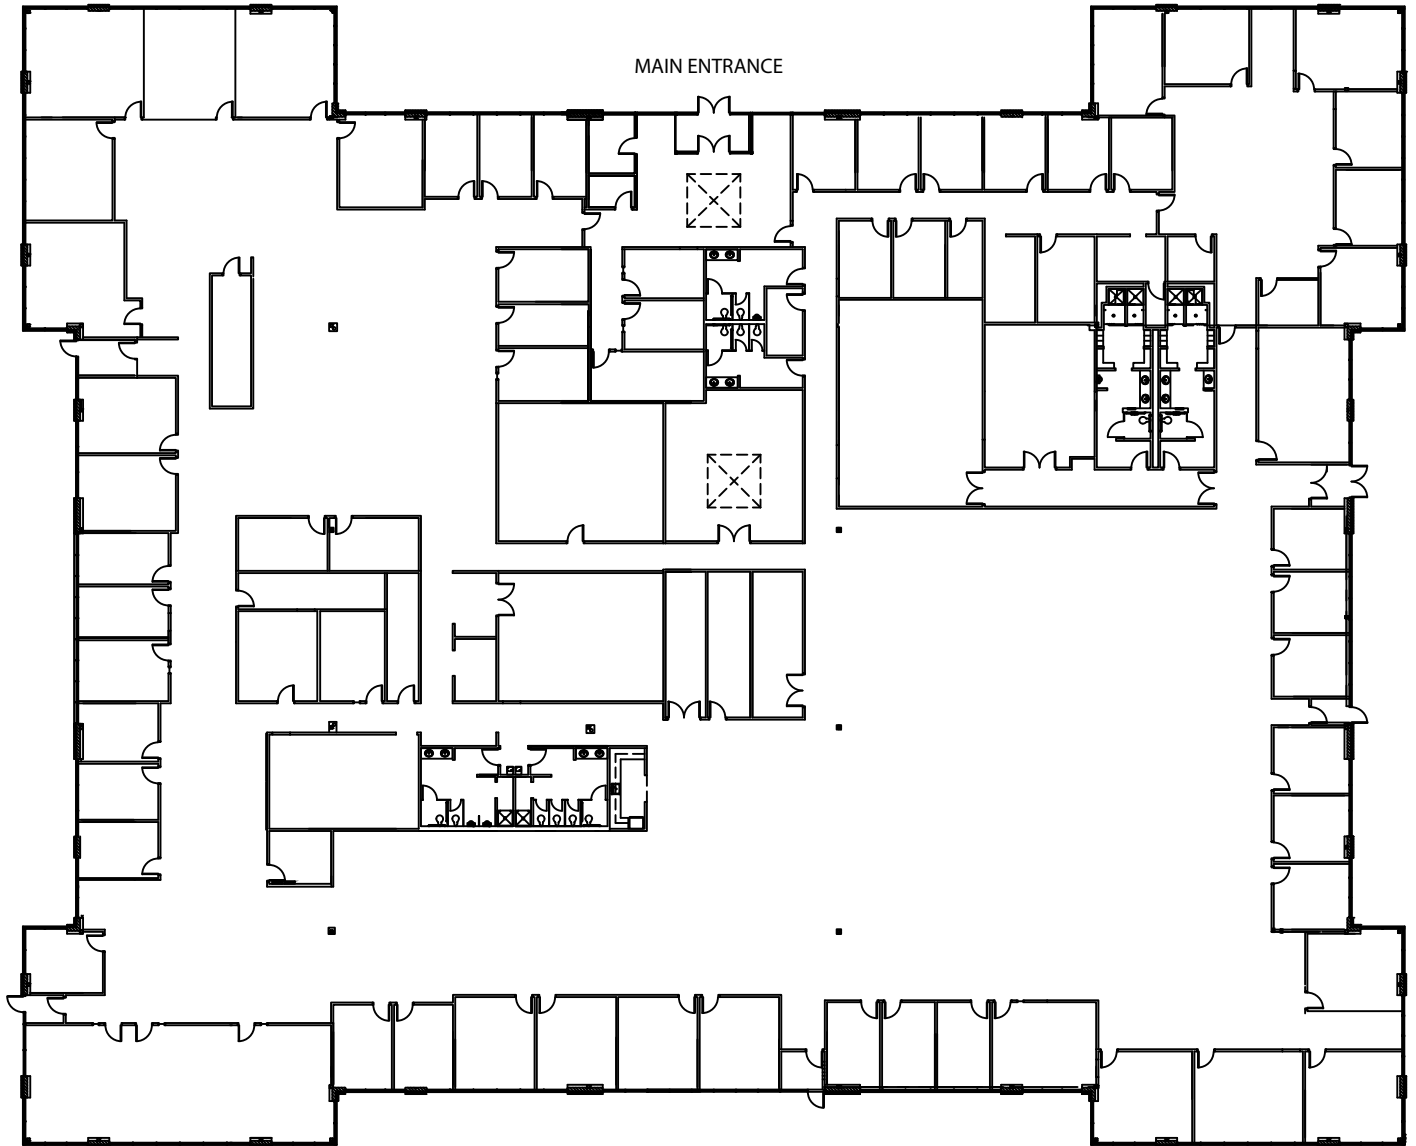

Master Floor Plan

SCALE: NTS

01/25/19

50,025 RSF

AS-BUILT PLAN FOR:
Beck Rd. Building
14909 Beck Rd., Plymouth, MI 48170

JFK INVESTMENT COMPANY, L.L.C.

A MICHIGAN LIMITED LIABILITY COMPANY
43252 WOODWARD AVE-SUITE 210-BLOOMFIELD HILLS, MI 48302
PHONE: (248) 333-2373 - FAX: (248) 333-2873