
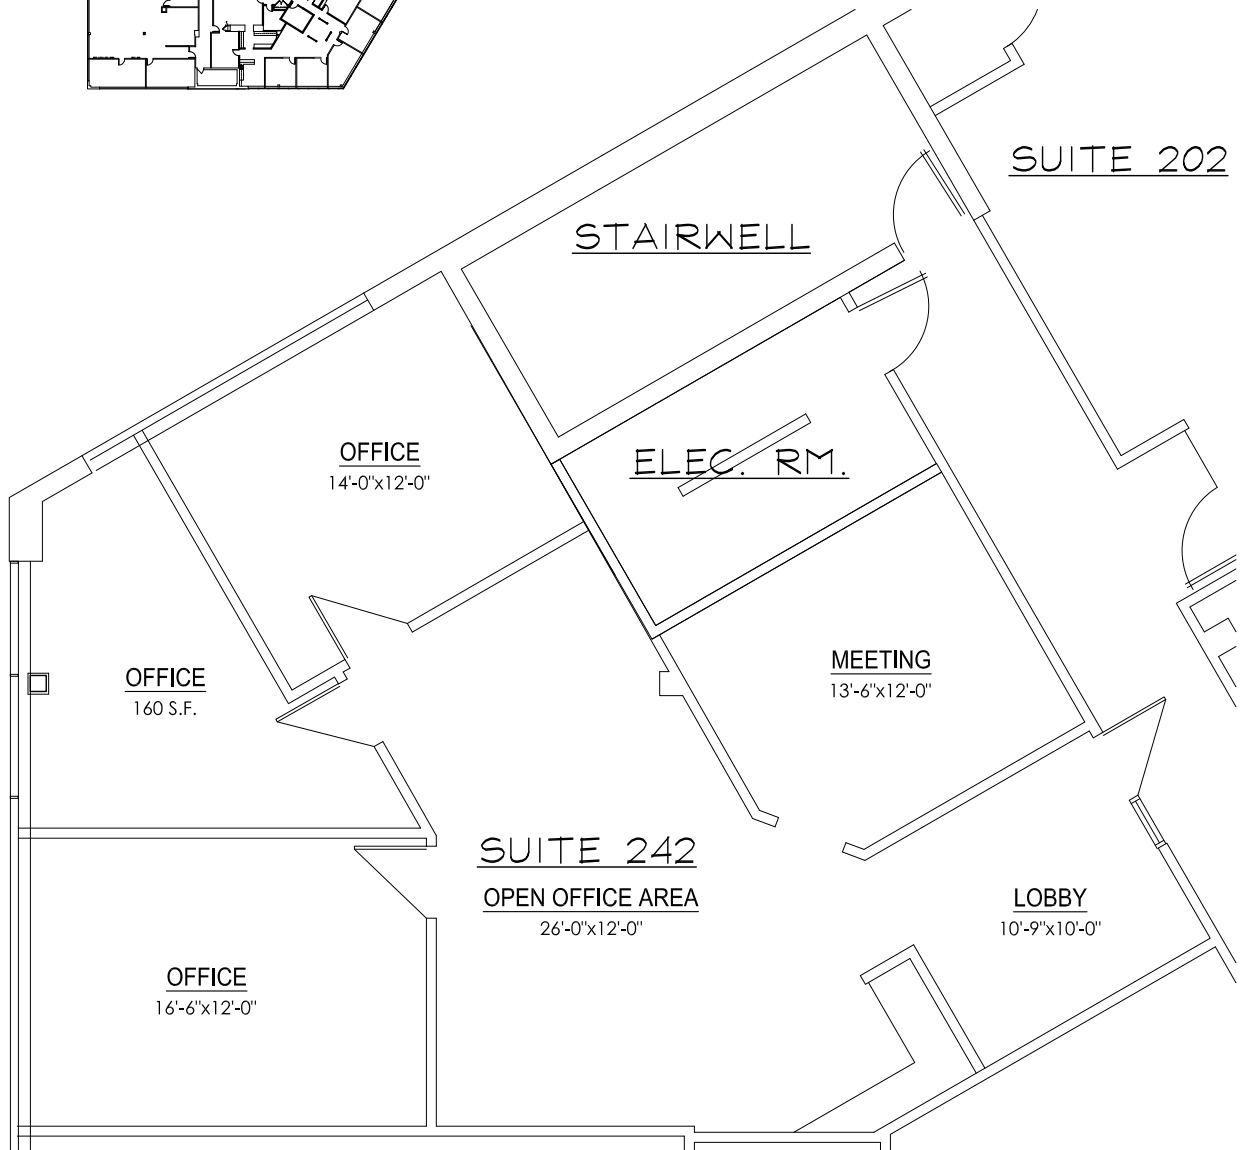


SUITE 242

2nd FLOOR KEYPLAN

(NOT TO SCALE)

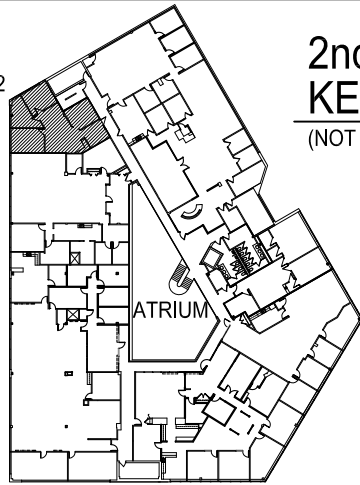

As-built Floor Plan

SCALE: 1"=10'-0"

07/11/16

1,359 R.S.F.

JFK INVESTMENTS COMPANY, L.L.C.

A MICHIGAN LIMITED LIABILITY COMPANY
 43252 WOODWARD AVE-SUITE 210-BLOOMFIELD HILLS, MI 48302
 PHONE: (248) 333-2373 - FAX: (248) 333-2873

EXISTING PLAN FOR:

Suite 242
 Winthrop Park Office Building
 43252 Woodward Avenue

smith + schurman associates, inc.
 architects ■ planners ■ interior designers

43252 woodward avenue, suite 208, bloomfield hills, mi 48302
 telephone: 248/332-3140 facsimile: 248/332-3277

