


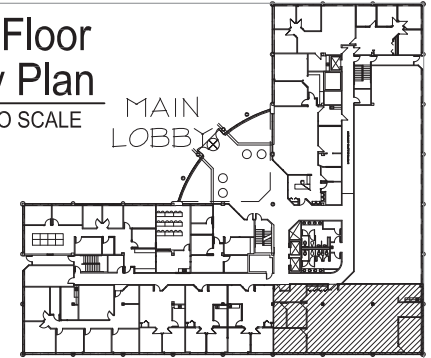


1st Floor Key Plan

NOT TO SCALE



MAIN LOBBY

SUITE 110

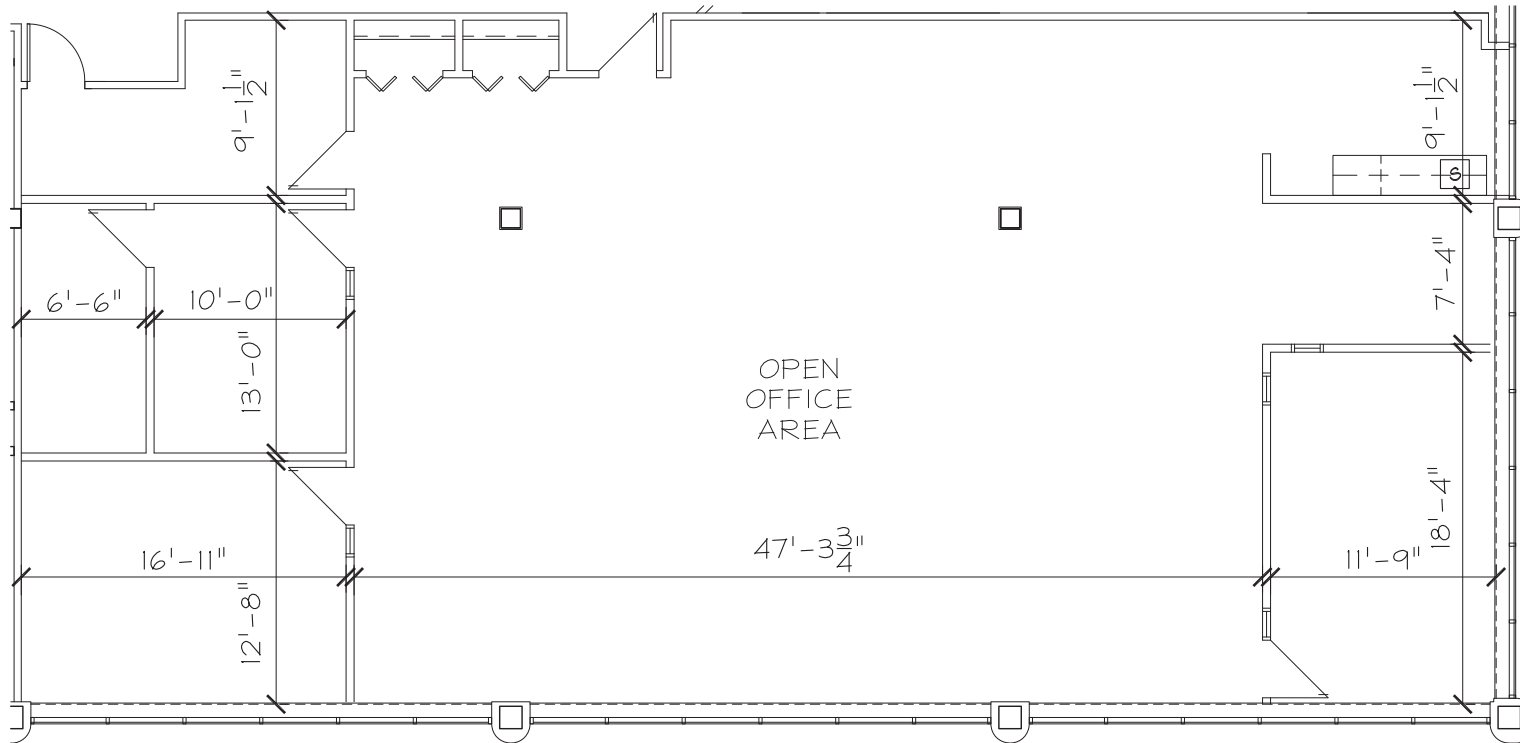

OPEN OFFICE AREA



Floor Plan

NOT TO SCALE

10/13/11

3,100 R.S.F.

JFK INVESTMENTS COMPANY, L.L.C.

A MICHIGAN LIMITED LIABILITY COMPANY
43252 WOODWARD AVE-SUITE 210-BLOOMFIELD HILLS, MI 48302
PHONE: (248) 333-2373 - FAX: (248) 333-2873

NOTE: DIMENSIONS ARE BASED ON DRAWINGS BY OTHERS AND SHOULD BE FIELD VERIFIED

AS-BUILT PLAN FOR:

39500 Orchard Hill Place, Suite 110
Novi, Michigan

smith + schurman associates, inc.
architects ■ planners ■ interior designers

43252 woodward avenue, suite 208, bloomfield hills, mi 48302
telephone: 248/332-3140 facsimile: 248/332-3277

