



### Suite 102


### As-Built Floor Plan

SCALE: 1/8"=1'-0"


04/20/17

2,005 U.S.F.

2,246 R.S.F.

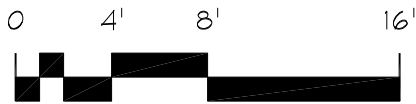

GRAPHIC SCALE

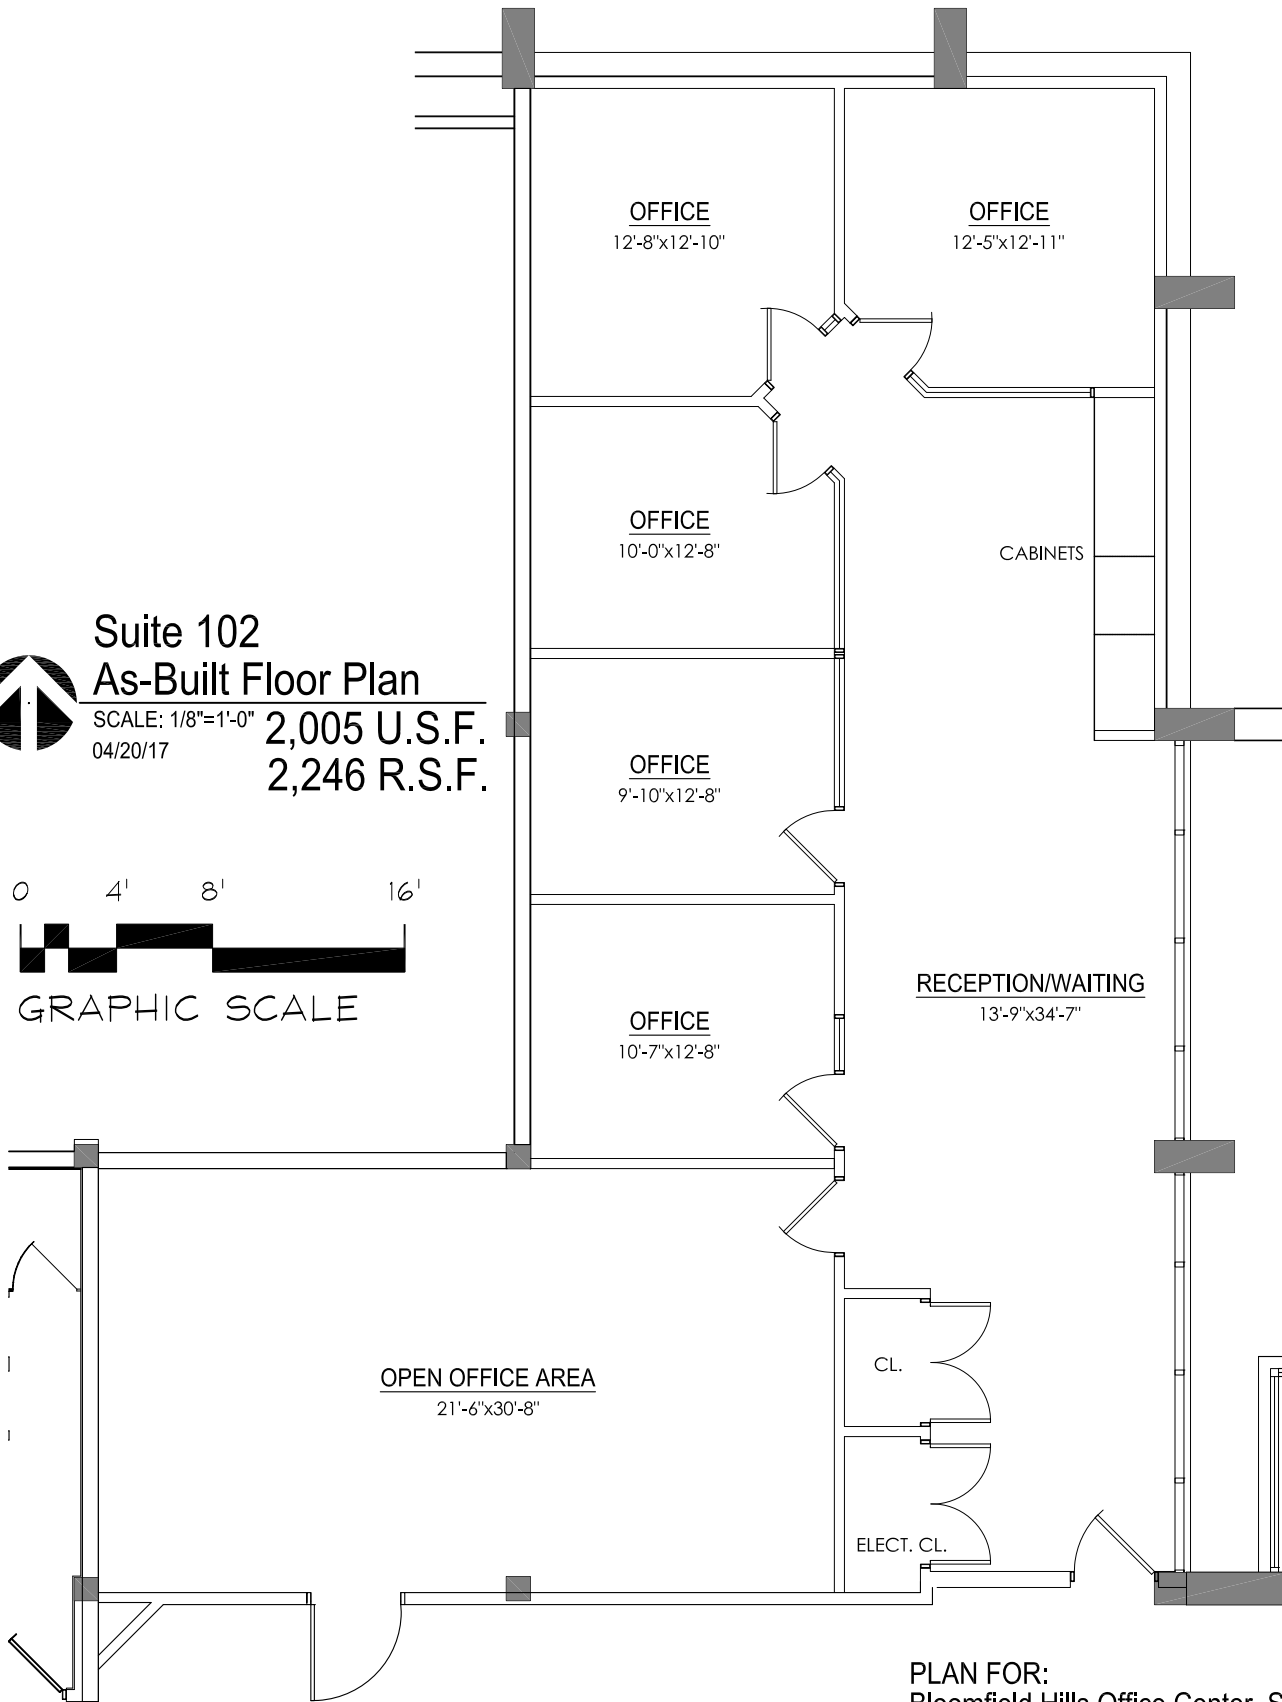

**JFK** INVESTMENT COMPANY, L.L.C.

A MICHIGAN LIMITED LIABILITY COMPANY  
43252 WOODWARD AVE-SUITE 210-BLOOMFIELD HILLS, MI 48302  
PHONE: (248) 333-2373 - FAX: (248) 333-2873

PLAN FOR:  
Bloomfield Hills Office Center, Suite 102  
40701 Woodward Avenue  
Bloomfield Hills, Michigan

smith + schurman associates, inc.  
architects ■ planners ■ interior designers

280 n. old woodward, suite LL10, birmingham, mi 48009  
telephone: 248/332-3140 facsimile: 248/332-3277

