
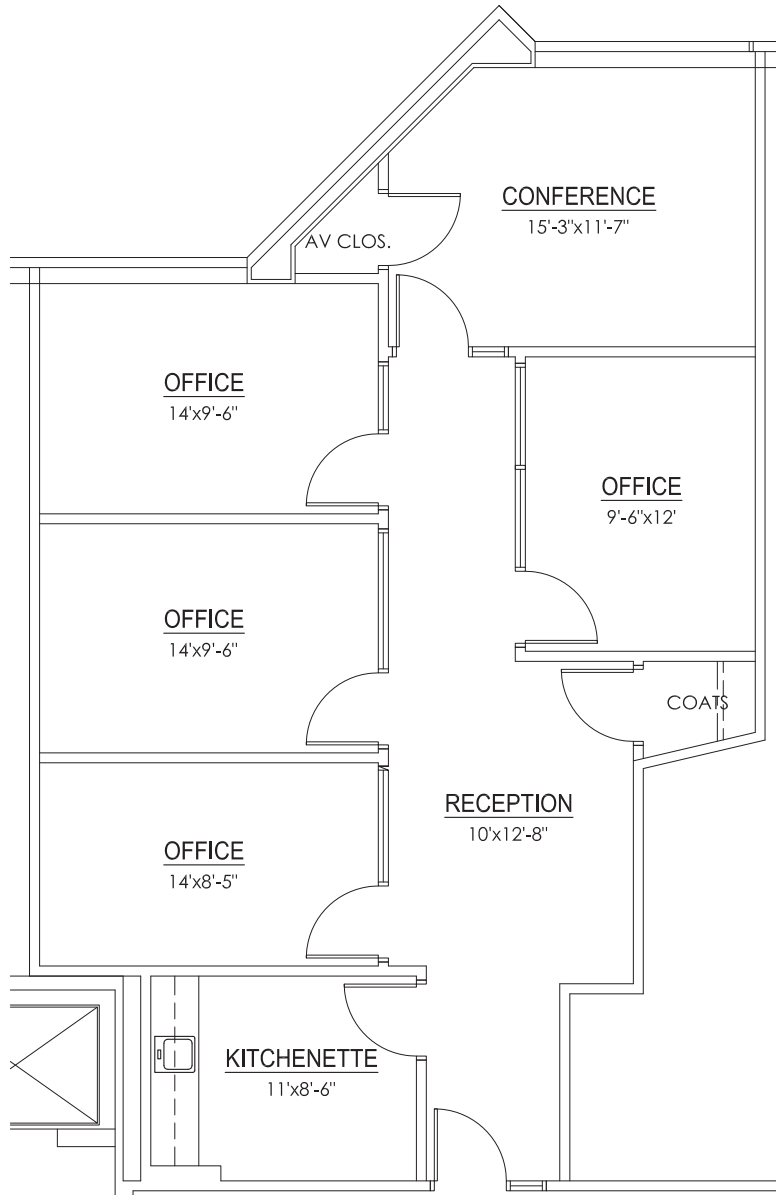


KEY PLAN
NOT TO SCALE

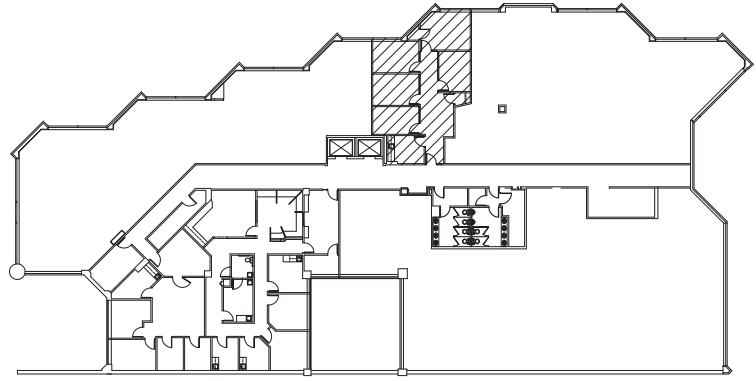

Floor Plan - Suite 220 - 1,374 RSF

SCALE: 1/8" = 1'-0" 03/01/17

JFK INVESTMENTS COMPANY, L.L.C.

A MICHIGAN LIMITED LIABILITY COMPANY
43252 WOODWARD AVE-SUITE 210-BLOOMFIELD HILLS, MI 48302
PHONE: (248) 333-2373 - FAX: (248) 333-2873

AS-BUILT PLAN:

280 North Old Woodward
Suite 220
Birmingham, Michigan 48009

smith + schurman associates, inc.
architects ■ planners ■ interior designers

280 n. old woodward, suite LL10, birmingham, mi 48009
telephone: 248/332-3140 facsimile: 248/332-3277

