


Ground Floor Keyplan

SCALE: 1"=80'-0"

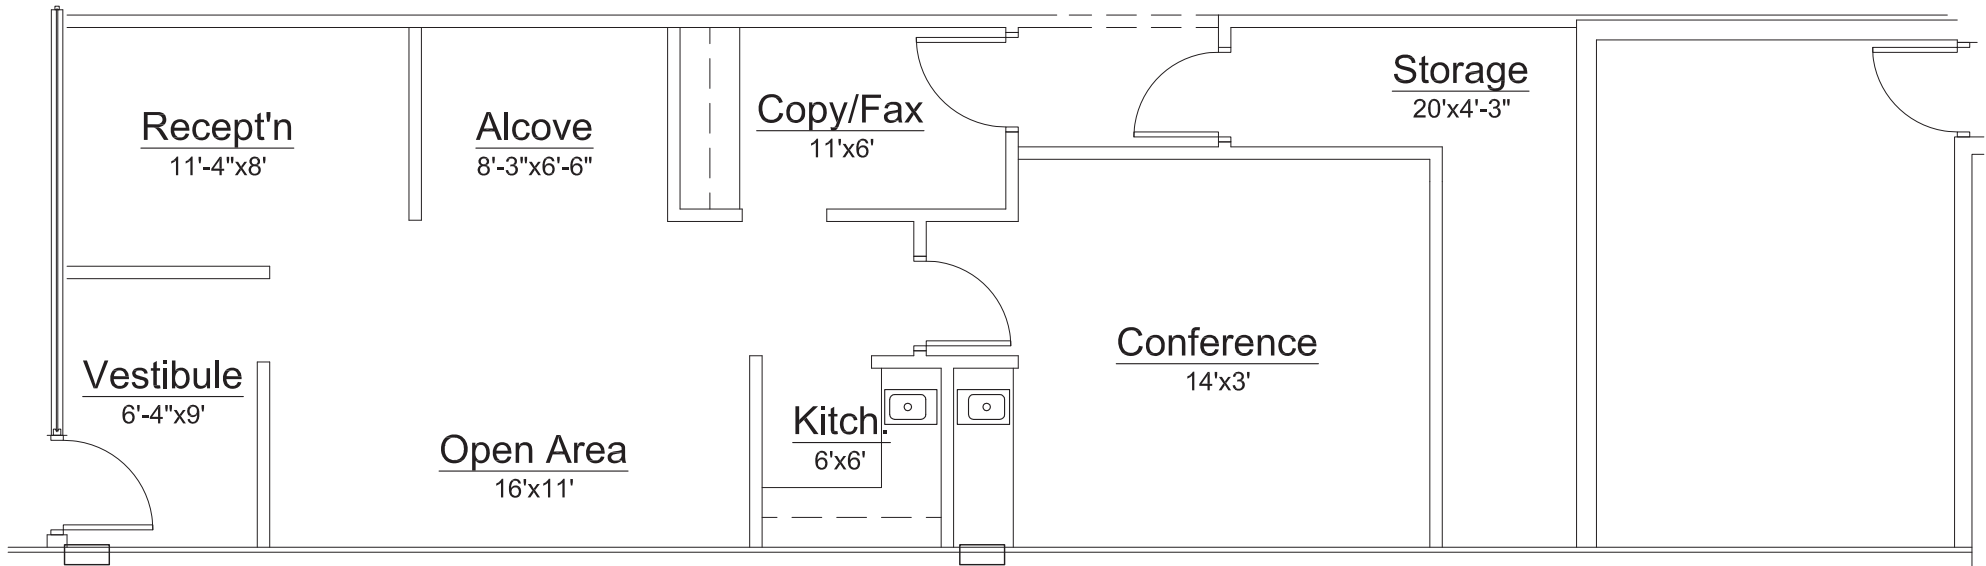

As-built Floor Plan - Suite107

SCALE: 1"=10'-0" 08/23/18

897 USF
1,005 RSF

JFK INVESTMENT COMPANY, L.L.C.

A MICHIGAN LIMITED LIABILITY COMPANY
43252 WOODWARD AVE-SUITE 210-BLOOMFIELD HILLS, MI 48302
PHONE: (248) 333-2373 - FAX: (248) 333-2873

EXISTING PLAN FOR:
Suite 107
280 N. Old Woodward
Birmingham, Michigan

smith+ schurman associates, inc.
architects ■ planners ■ interior designers

280 n. old woodward, suite 1110, birmingham, mi 48009
telephone: 248/332-3140 facsimile: 248/332-3277

