


**Ground Floor Keyplan**

SCALE: 1"=80'-0"



250 USF / 286 RSF  
LOFT/MEZZANINE ABOVE  
(DELINEATED BY  
DOTTED LINE)

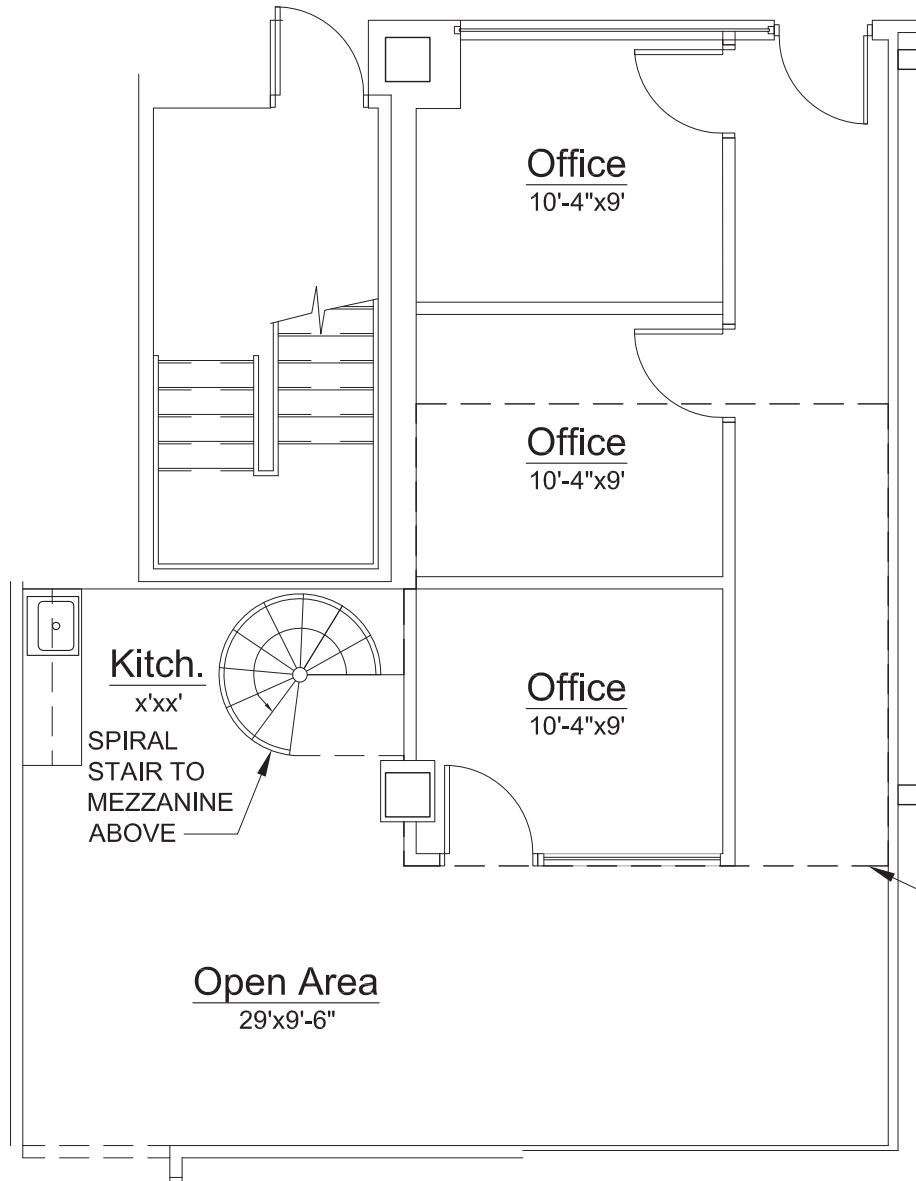

**As-built Floor Plan - Suite 105**

SCALE: 1"=10'-0" 08/23/18

**868 USF**

**972 RSF**

**JFK INVESTMENT COMPANY, L.L.C.**

A MICHIGAN LIMITED LIABILITY COMPANY  
43252 WOODWARD AVE-SUITE 210-BLOOMFIELD HILLS, MI 48302  
PHONE: (248) 333-2373 - FAX: (248) 333-2873

**EXISTING PLAN FOR:**

Suite 105  
280 N. Old Woodward  
Birmingham, Michigan

smith+schurman associates, inc.  
architects ■ planners ■ interior designers

280 n. old woodward, suite 1110, birmingham, mi 48009  
telephone: 248/332-3140 facsimile: 248/332-3277

