


SUITE 355



3rd Floor Keyplan

NOT TO SCALE

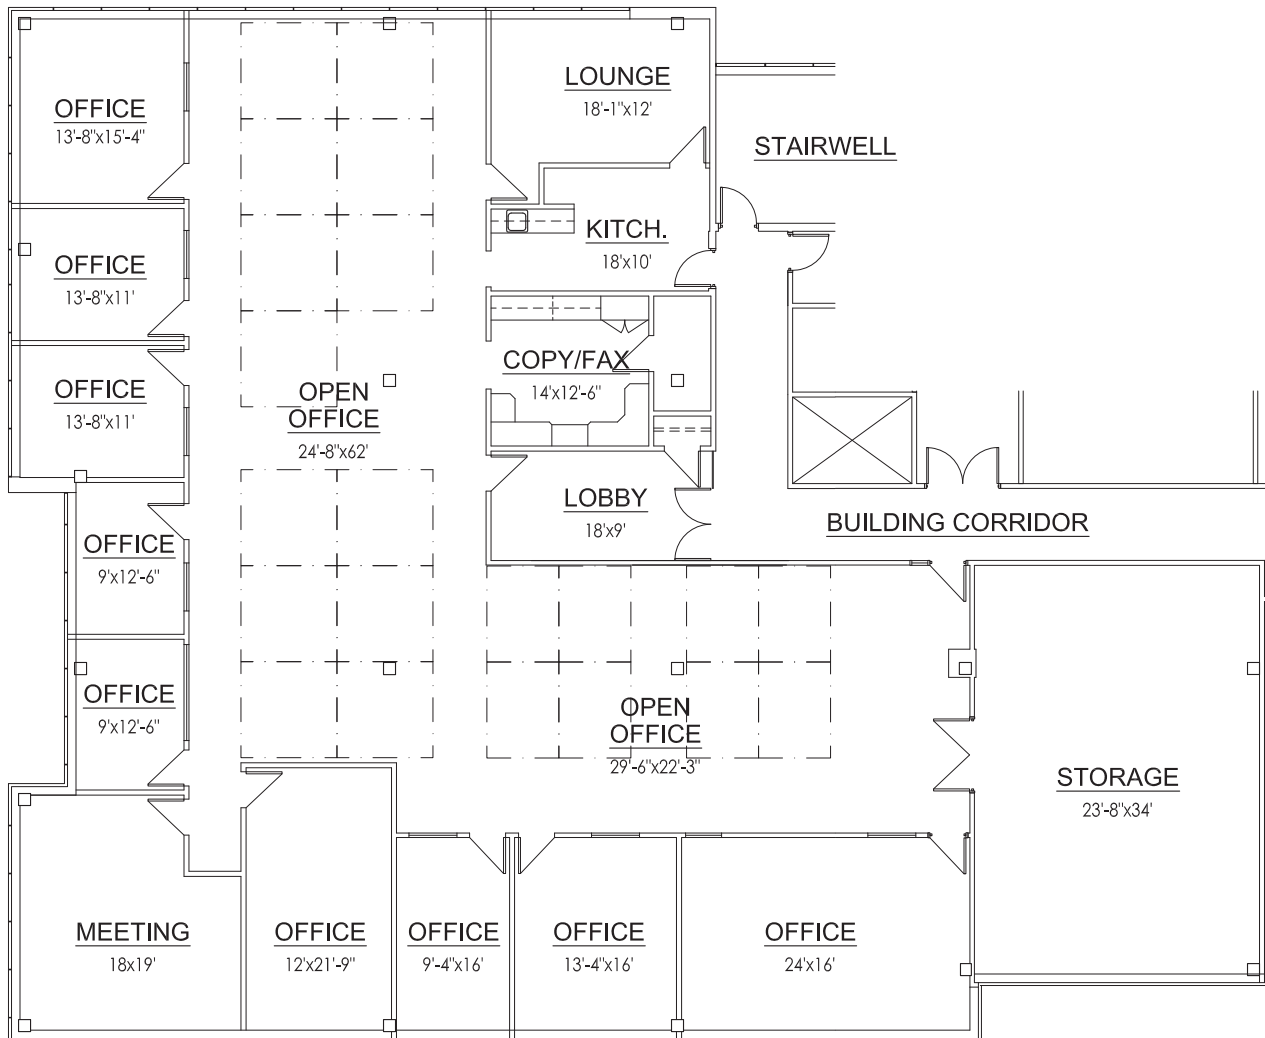

Existing Floor Plan

7,337 R.S.F.

SCALE 1/16"=1'-0" 02/08/17

JFK INVESTMENTS COMPANY, L.L.C.

A MICHIGAN LIMITED LIABILITY COMPANY
 43252 WOODWARD AVE-SUITE 210-BLOOMFIELD HILLS, MI 48302
 PHONE: (248) 333-2373 - FAX: (248) 333-2873

AS-BUILT PLAN FOR:
 West Hills II Office Building
 34119 West Twelve Mile Road, Suite 355
 Farmington Hills, Michigan

smith + schurman associates, inc.
 architects ■ planners ■ interior designers

280 n. old woodward avenue, suite LL10, birmingham, mi 48009
 telephone: 248/332-3140 facsimile: 248/332-3277

