



SUITE 152

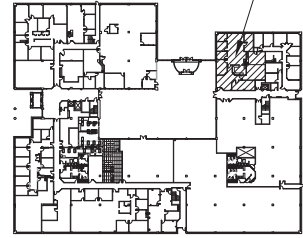

KEY PLAN

NOT TO SCALE

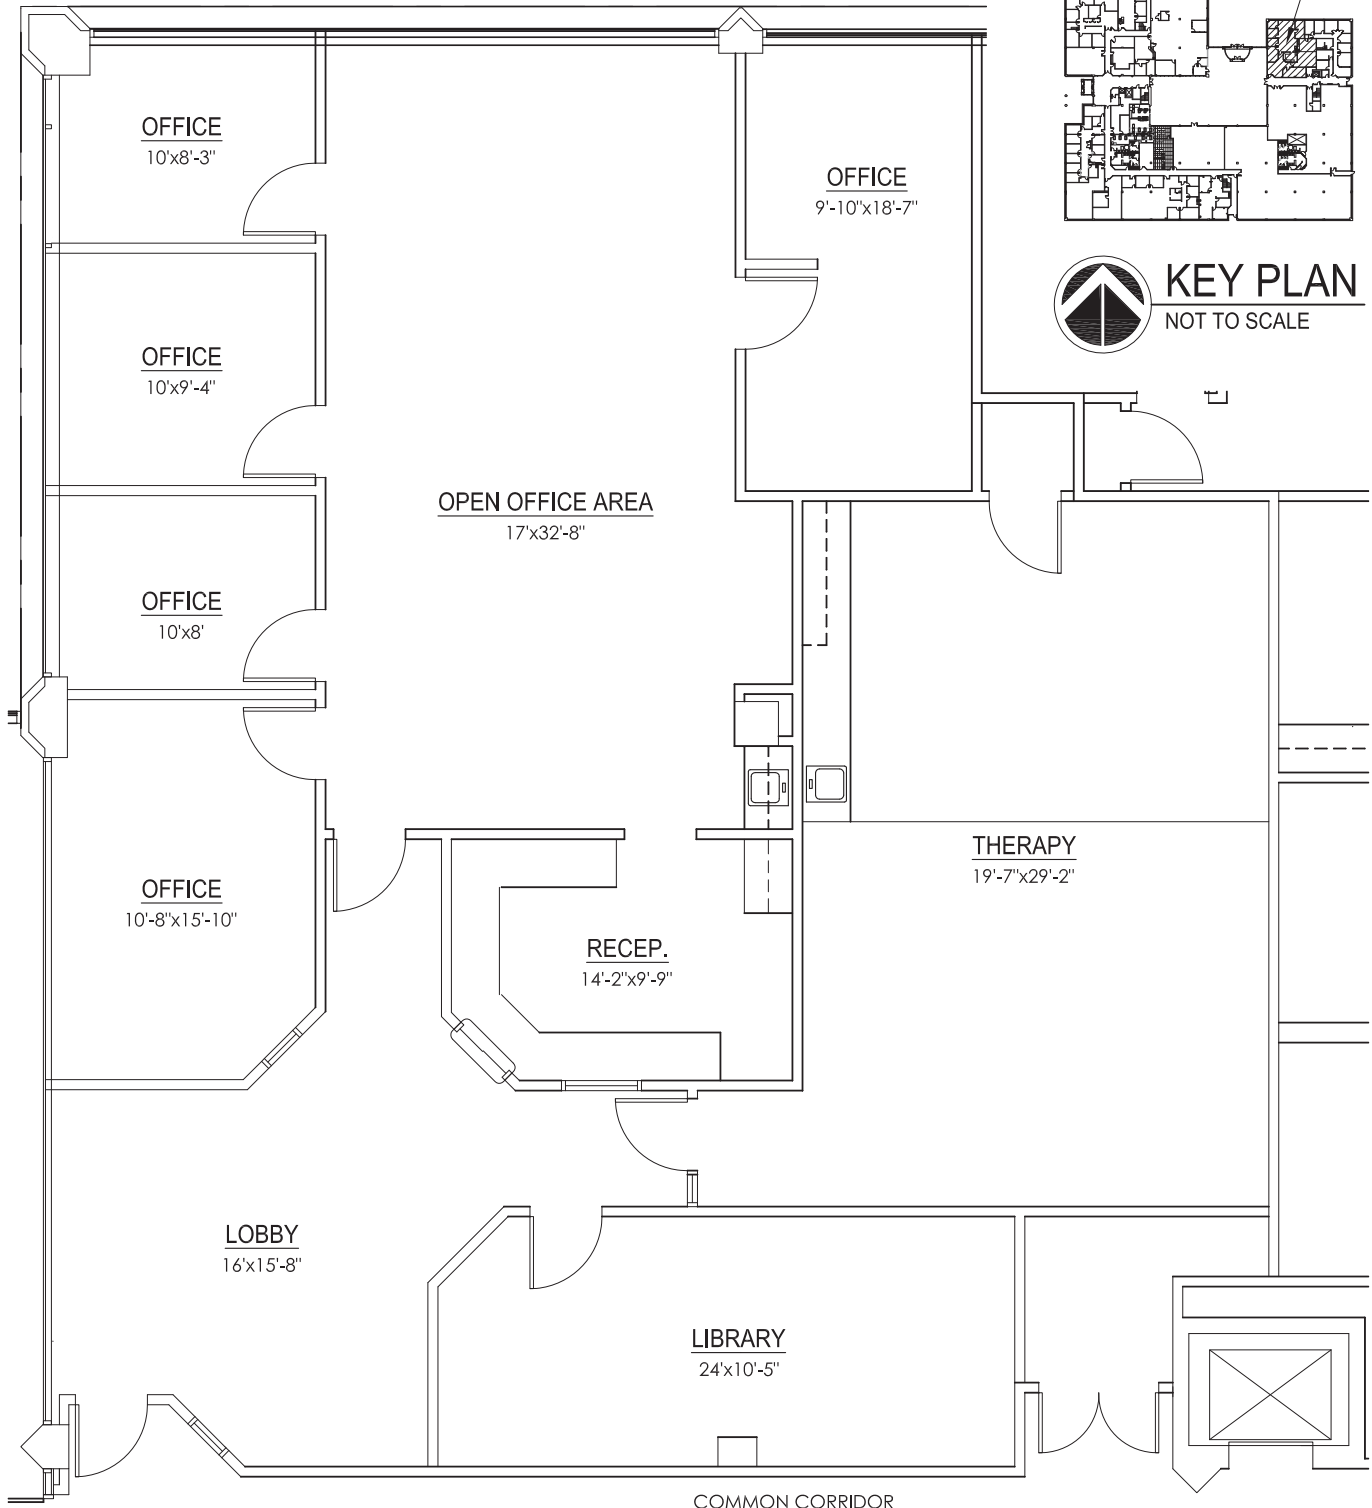

Suite 152

3,142 R.S.F.

SCALE: 1/8" = 1'-0"

07/23/19

AS-BUILT PLAN FOR:

Suite 152

Gateway Building

33533 W. 12 Mile, Farmington, MI 48334

JFK INVESTMENT COMPANY, L.L.C.

A MICHIGAN LIMITED LIABILITY COMPANY
43252 WOODWARD AVE-SUITE 210-BLOOMFIELD HILLS, MI 48302
PHONE: (248) 333-2373 - FAX: (248) 333-2873

smith + schurman associates, inc.
architects ■ planners ■ interior designers

280 n. old woodward, suite LL10, birmingham, mi 48009
telephone: 248/332-3140 facsimile: 248/332-3277

