


2nd Flr. Keyplan


SCALE: 1"=100'-0"

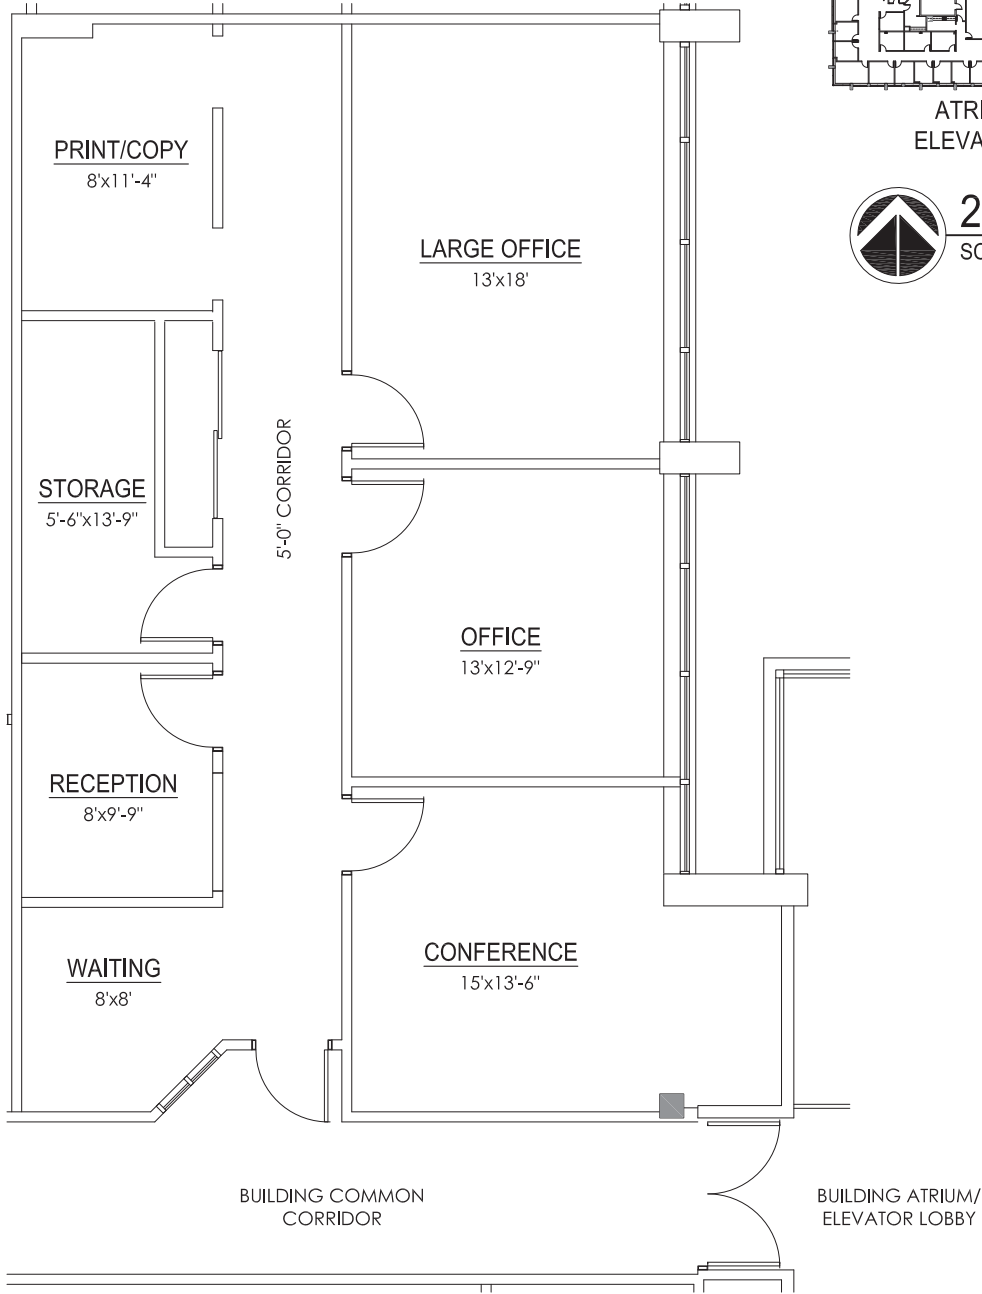

Suite 245 - 1,469 RSF
As-Built Floor Plan

SCALE: 1/8"=1'-0"

07/30/20

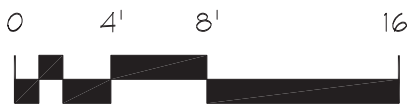

GRAPHIC SCALE

PLAN FOR:
Bloomfield Hills Office Center, Suite 245
40701 Woodward Avenue
Bloomfield Hills, Michigan



JFK INVESTMENT COMPANY, L.L.C.

A MICHIGAN LIMITED LIABILITY COMPANY
43252 WOODWARD AVE-SUITE 210-BLOOMFIELD HILLS, MI 48302
PHONE: (248) 333-2373 - FAX: (248) 333-2873

smith + schurman associates, inc.
architects ■ planners ■ interior designers

280 n. old woodward, suite LL10, birmingham, mi 48009
telephone: 248-203-6249

