


LENGTH OF WALL: 70'

NUMBER OF CAR TIRES: 364

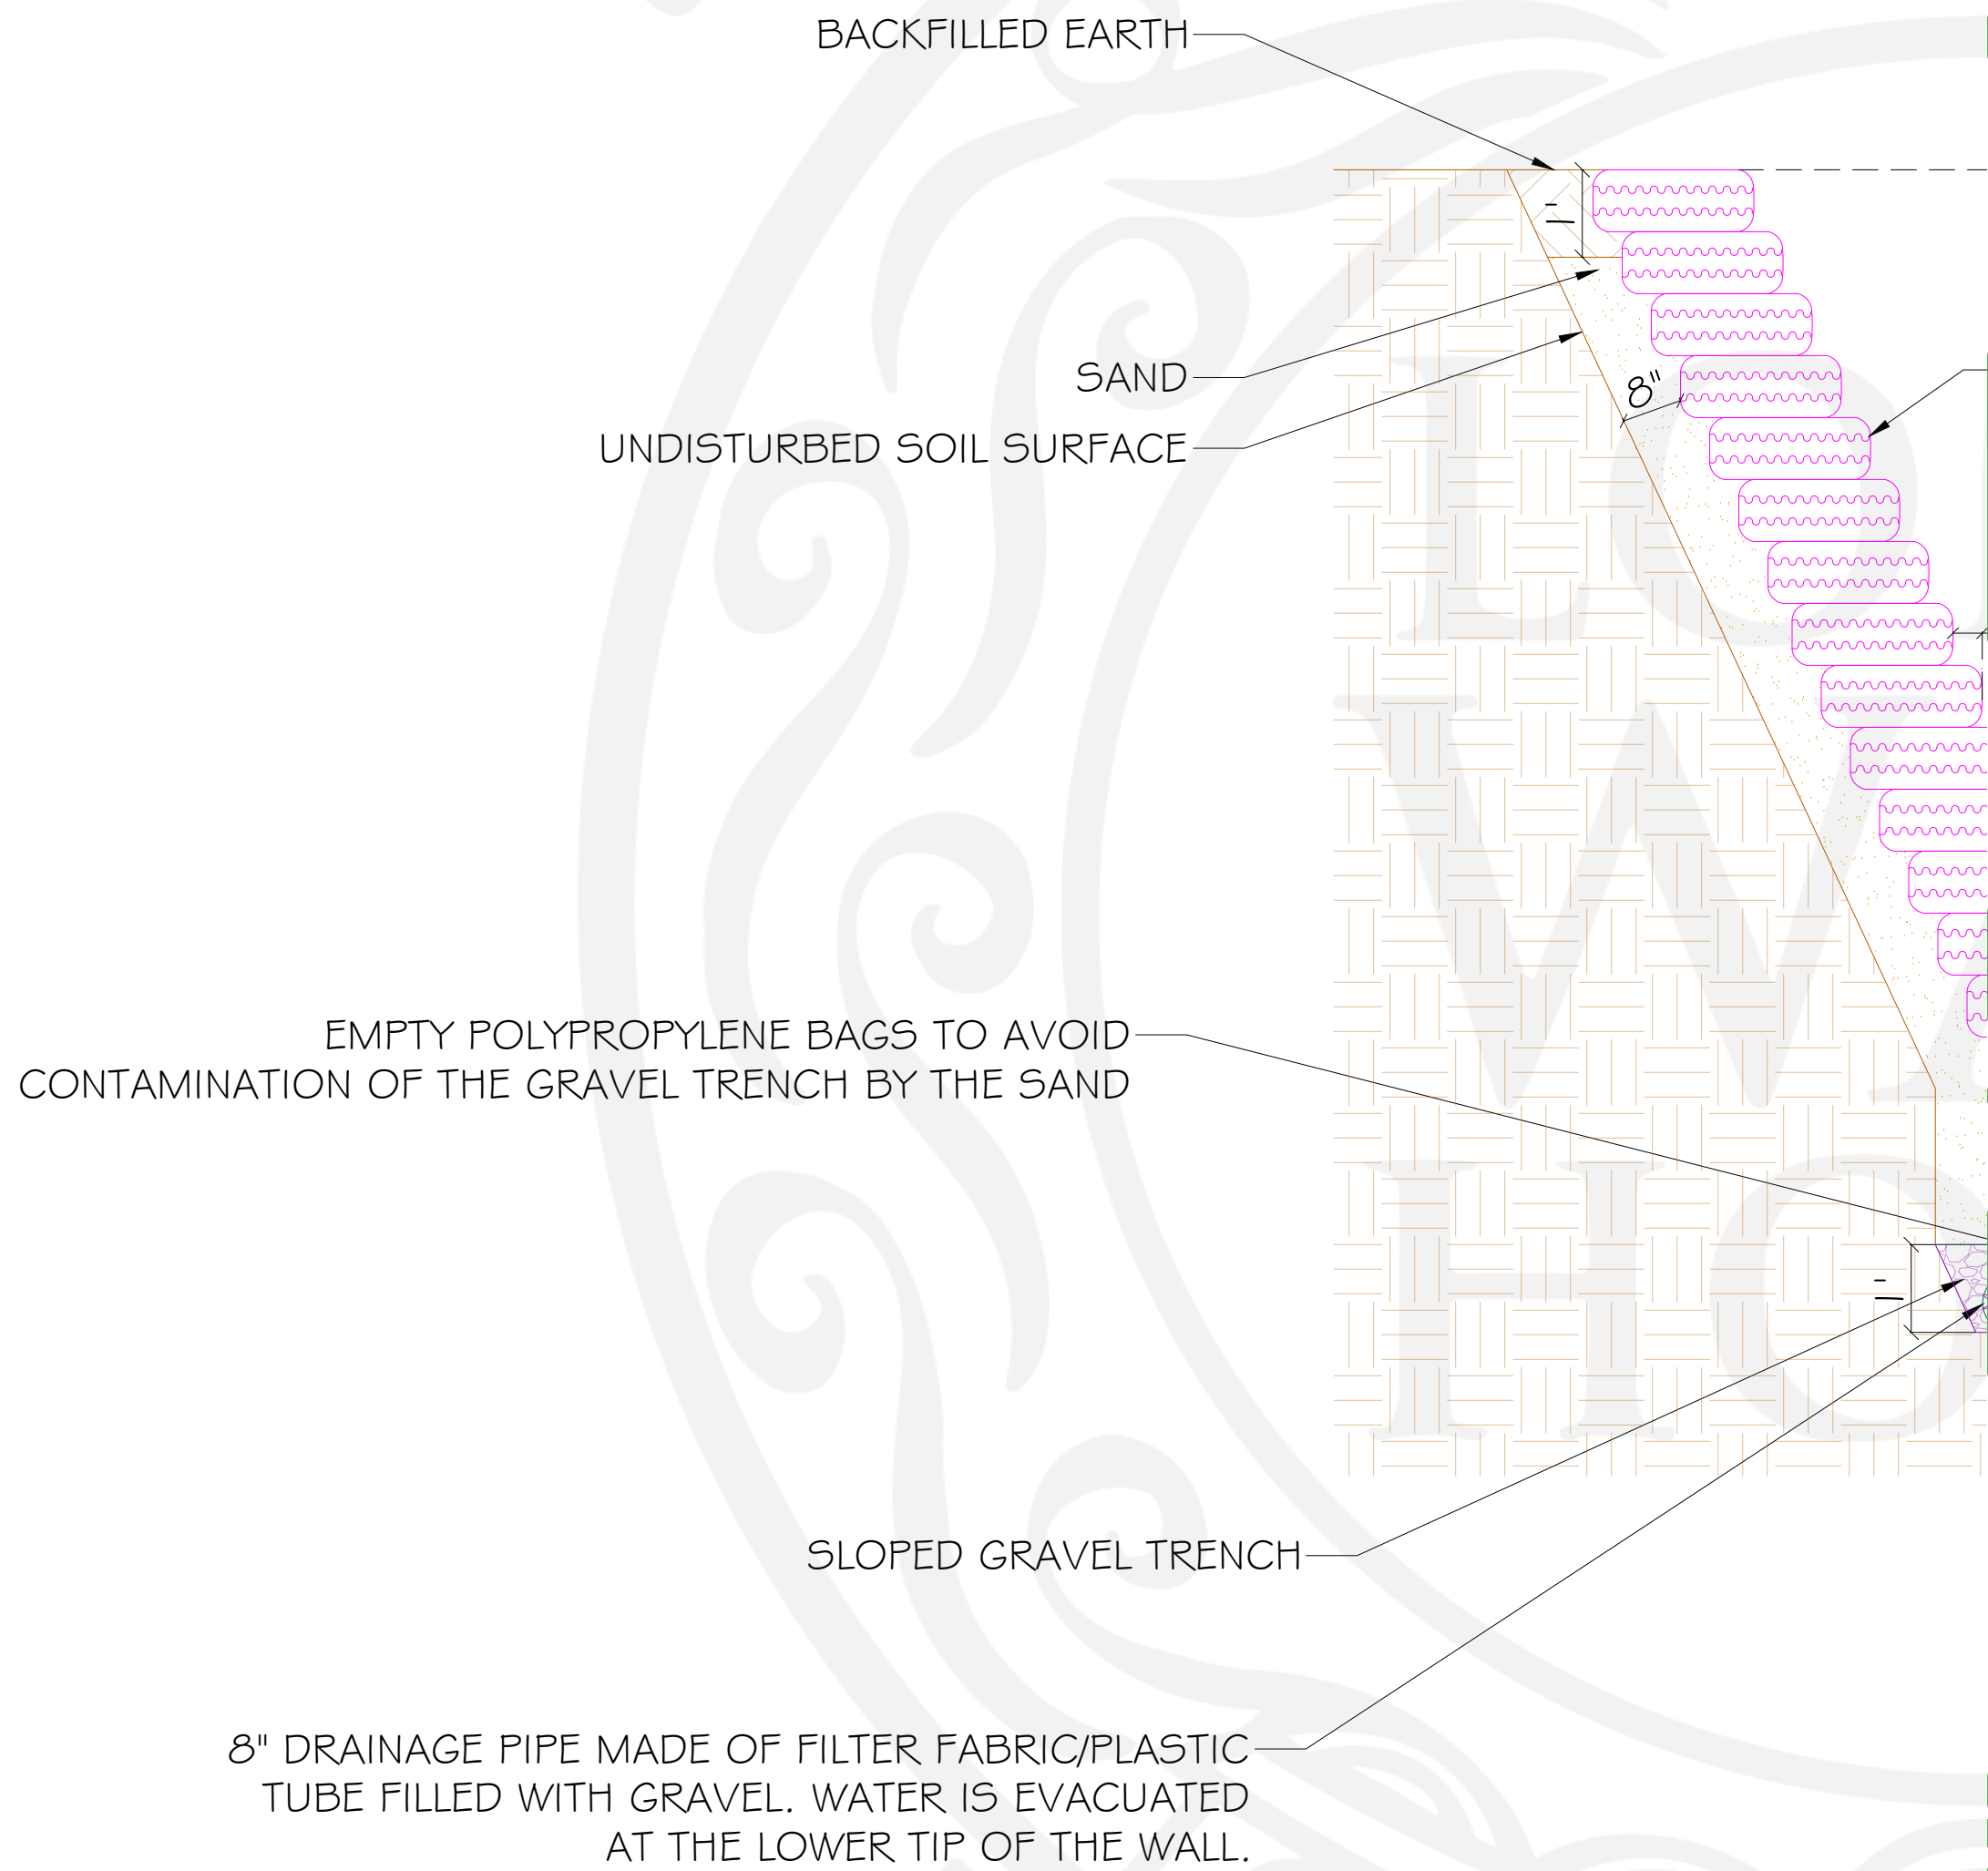

1 RETAINING WALL 8

1/2" = 1' - 0"

- NOTES:
1. THIS DRAWING IS A CAD DRAWING AND SHOULD NOT BE ALTERED MANUALLY.
 2. THIS DRAWING MUST NOT BE USED FOR CONSTRUCTION UNLESS APPROVED OTHERWISE.
 3. ALL DRAWINGS SHALL BE READ IN CONJUNCTION WITH ALL OTHER CONSULTANTS DRAWINGS AND SPECIFICATIONS.
 4. THIS DOCUMENT MAY ONLY BE USED BY LONG WAY HOME'S CLIENT (AND ANY OTHER PERSON WHO LWH HAS GIVEN PERMISSION TO USE THIS DOCUMENT) FOR THE PURPOSE FOR WHICH IT WAS PREPARED AND MUST NOT BE USED BY ANY OTHER PERSON OR FOR ANY OTHER PURPOSE.
 5. THIS DRAWING IS PROTECTED BY INTERNATIONAL COPYRIGHT LAW.

MATERIALS KEY:

- TIRE
- CONCRETE
- FILTER FABRIC/PLASTIC
- SAND
- GRAVEL
- UNDISTURBED EARTH
- BACKFILLED EARTH

LONG WAY HOME

SAN JUAN COMALAPA, GUATEMALA

WWW.LWHOME.ORG

INFO@LWHOME.ORG

PROJECT:

HERO SCHOOL

HERO SCHOOL

BUILDING:

MID-CAMPUS TIRE

RETAINING WALL

NO:

21

REVISIONS:			
NO.	DATE	DESC	DRAWN BY
1	02/08/2021	AS BUILT	S.M.

DRAWN BY:

GERMAIN HOT

DATE:

2 AUGUST 2021

SHEET TITLE:

RETAINING WALL 8

SCALE:

1/2" = 1'-0"

SHEET SIZE:

A1

SHEET NO.

21-200

PAGE 1 OF 1